

**NOTE;**  
**CONSTRUCTION SREB:**  
**SREB # 1 SHALL BE A HEATED SREB**  
**SREB #2 SHALL BE A HEATED SREB**

## CODE SYNOPSIS

2009 IBC AS AMENDED BY ALASKA DEPT. OF PUBLIC SAFETY

OCCUPANCY S-1 PARKING GARAGE (IBC 311.3)

CONSTRUCTION TYPE V-B COMBUSTIBLE WITH NO FIRE RESISTANCE  
 MINIMUM FIRE SEPARATION = 10' CLEAR OR GREATER (IBC 602)

FIRE SEPARATION DISTANCE (702); 10'  
 BUILDING FACE TO

- 1) CLOSEST INTERIOR LOT LINE
- 2) CENTER OF PUBLIC WAY
- 3) IMAGINARY LINE BETWEEN 2 BUILDINGS = 20'

ACTUAL AREA: 26' x 50' = 1,300 S.F.

S-1 OF V-B ALLOWABLE AREA = 13,500SF (IBC 503) = OK

FIRE SEPARATION NOT REQUIRED FOR FUEL - HEATING EQUIPMENT UNDER 400,000 BTU INPUT (IBC 508.2)

OCCUPANT EXIT LOAD (IBC 1004.1); 1,300SF/200 = 6.5 = SINGLE 36" HINGED EXIT DOOR ok (1015)


FOAM PLASTIC INSULATED WALL & ROOF PANELS SHALL COMPLY WITH IBC 2603 FOR NON-SPRINKLERED BUILDINGS

FE PROVIDE TWO EXTINGUISHERS WITH ENCLOSURE CABINETS: DRY CHEMICAL 2-A: 10-B;C MINIMUM WITH ALASKA FIRE MARSHAL - APPROVED SIGNS

## SHEET NOTES

PROVIDE EQUIPMENT UNPACKED, ASSEMBLED AND READY TO USE; LOCATE WHERE DIRECTED BY OWNER

- 1 PORTABLE LADDER: FURNISH ONE PORTABLE ALUMINUM ADJUSTABLE FREE STANDING A-FRAME LADDER 6 TO 11 FOOT A-FRAME HEIGHT RECOMMENDED BY MANUFACTURER FOR INDUSTRIAL HEAVY DUTY 300 POUND RATING. CERTIFIED ANSI A14 COMPLIANCE [little giant.com](http://little giant.com) - MODEL 26 OR EQUAL. INSTALL WITH STORAGE 1/8" X 3/4" GALVANIZED CHAIN AGAINST ON INSIDE WALL OF BUILDING WHERE DIRECTED BY OWNER.
- 2 TWO 16" WIDE X 3/4" PLYWOOD SHELVES - BETWEEN FRAMING - 12" X 12" STEEL SHELF BRACKETS EVENLY SPACED AT 24" O.C. - 55" AND 68" FROM TOP TO FLOOR - PAINT SAME AS PLYWOOD WAINSCOT
- 3 SPILL CONTAINMENT CABINET  
 14 GAGE STEEL 48" WIDE X 24" DEEP X 78" HIGH WITH 2 PAD LOCKABLE DOORS.  
 CENTER PARTITION, COAT ROD, FIXED TOP SHELF, 4 ADJUSTABLE SHELVES.  
 YELLOW ENAMEL PAINT FINISH WITH "SPILL CONTAINMENT CABINET" IN 2" HIGH LETTERS.  
[WWW.LKGOODWIN.COM](http://WWW.LKGOODWIN.COM) MODEL ML248 OR EQUAL  
 INSTALL WHERE DIRECTED
- 4 2 EACH 5000 LB CAPACITY FLOOR MOUNT SINGLE SIDE CANTILEVER RACK:  
 (2) 8" HIGH UPRIGHTS  
 (1) BRACE SET BETWEEN UPRIGHTS; 6"  
 (10) 24" STRAIGHT ARMS WITH LIPS  
 ENAMEL PAINT FINISH  
[WWW.LKGOODWIN.COM](http://WWW.LKGOODWIN.COM) SERIES 1000 OR EQUAL  
 INSTALL WHERE DIRECTED
- 5 (2 EACH) CLOSED SHELF UNITS: 18 GAGE STEEL 48" WIDE X 24" DEEP 39" HIGH WITH CLOSED SIDES & BACK.  
 (3) INTERMEDIATE ADJUSTABLE SHELVES  
 GRAY ENAMEL PAINT FINISH  
[WWW.LKGOODWIN.COM](http://WWW.LKGOODWIN.COM) IRONMAN OR EQUAL  
 INSTALL WHERE DIRECTED

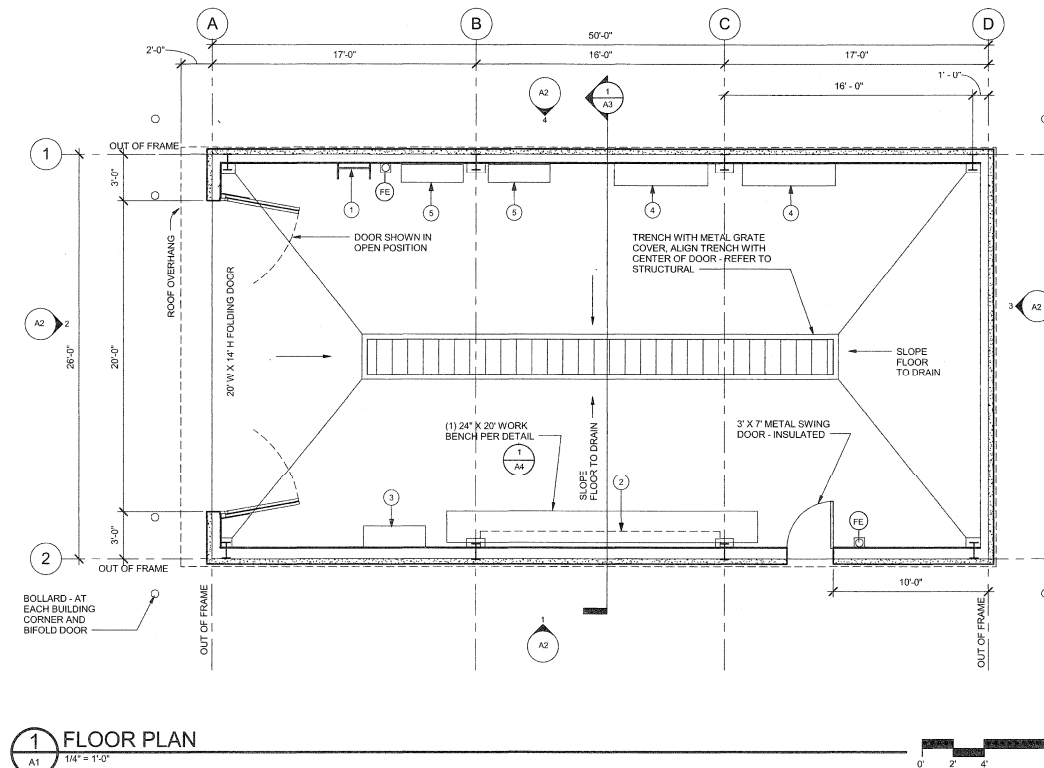

**1 FLOOR PLAN**  
 A1 1/4" = 1'-0"



PLANS DEVELOPED BY:  
 MOD ARCHITECTS  
 PROJ. NO. 2010039.09

BY	DATE	REVISION





**STATE OF ALASKA**  
**DEPARTMENT OF TRANSPORTATION**  
**AND PUBLIC FACILITIES**  
**CENTRAL REGION**

**HOOPER BAY, AIRPORT**  
 HOOPER BAY, ALASKA  
 AIRPORT IMPROVEMENTS  
 PROJECT No. 59276  
 AIP No. 3-02-0424-056-2014  
 FLOOR PLAN

DATE:  
 04/04/2015  
 SHEET:  
 A1 of A5  
 AS-BUILT SHEET

**AS-BUILT**  
 Project Engineer: *[Signature]* Date: 3/1/18  
 Hooper Bay Airport Improvements 57419

Date: 04/04/2015  
 Drawn By: J. E. McCool  
 Checked By: J. E. McCool  
 Project: HOOPER BAY AIRPORT IMPROVEMENTS  
 File Path: \\sdc\projects\2015\Hooper Bay Airport Improvements\04-Exterior Elevations

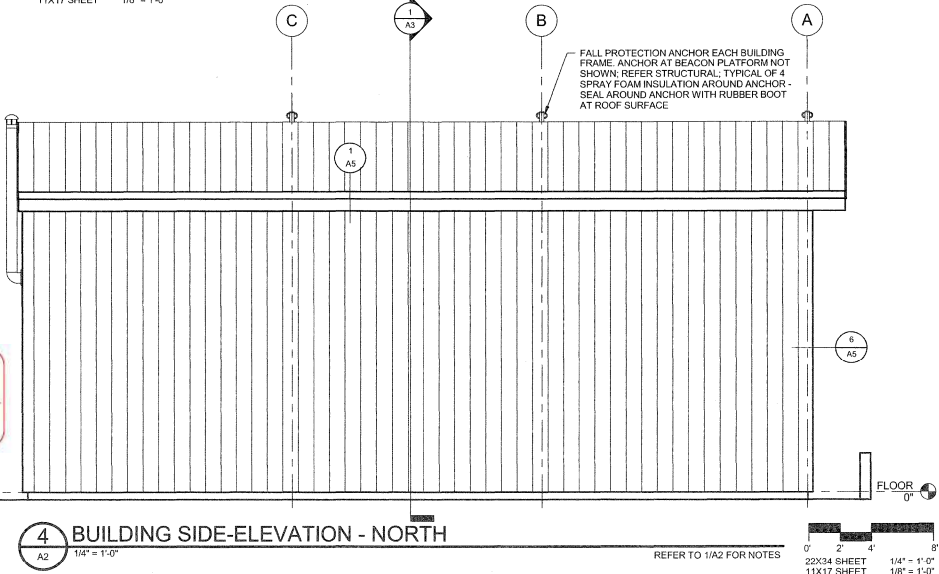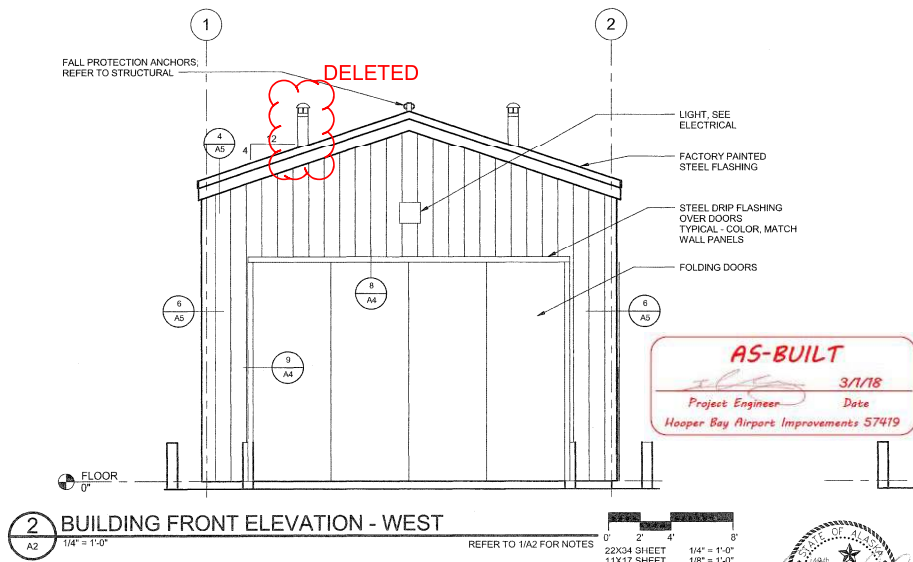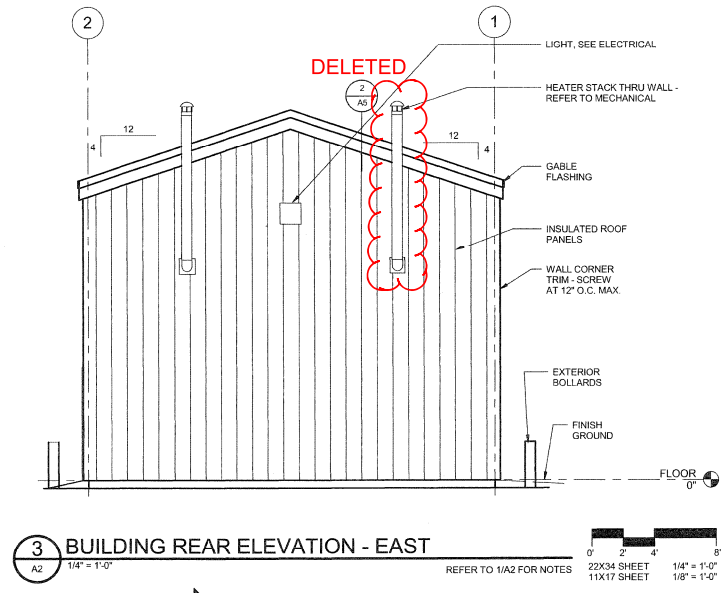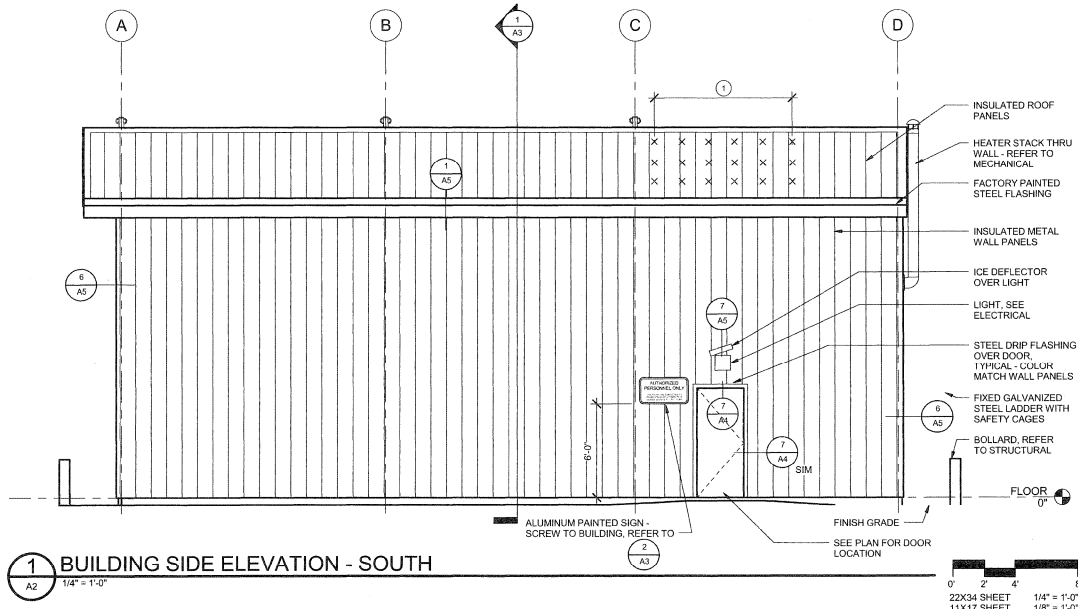

## SHEET NOTES

- INSTALL ON ROOF CENTERED ABOVE MAIN DOOR 4" UP FROM EAVE - SPACE 4" UP ROOF SLOPE  
2" TO 3" PROJECTION POLYCARBONATE PLASTIC RECOMMENDED BY MANUFACTURER TO HOLD  
SNOW ONTO SLOPING ROOFS ATTACH WITH MANUFACTURER APPROVED ADHESIVE  
POLAR BLOX, SNOWJAX, SNO GEM EQUAL



04/04/2015  
 PLAND DEVELOPED BY:  
 MCG ARCHITECTS  
 PROJ. NO. 2010039.09


BY	DATE	REVISION

STATE OF ALASKA  
 DEPARTMENT OF TRANSPORTATION  
 AND PUBLIC FACILITIES  
 CENTRAL REGION

HOOPER BAY, ALASKA  
 HOOPER BAY, ALASKA  
 AIRPORT IMPROVEMENTS  
 PROJECT No. 59276  
 AIP No. 542-0474-016-2014  
 EXTERIOR ELEVATIONS


DATE:  
 04/04/2015  
 SHEET:  
 A2 OF A5  
 AS-BUILT SHEET

1. 1/2" = 1'-0" (1/2" = 1'-0")  
 2. 1/4" = 1'-0" (1/4" = 1'-0")  
 3. 3/4" = 1'-0" (3/4" = 1'-0")  
 4. 1/2" = 1'-0" (1/2" = 1'-0")  
 5. 1/4" = 1'-0" (1/4" = 1'-0")  
 6. 1/2" = 1'-0" (1/2" = 1'-0")  
 7. 1/4" = 1'-0" (1/4" = 1'-0")  
 100. 1/2" = 1'-0" (1/2" = 1'-0")

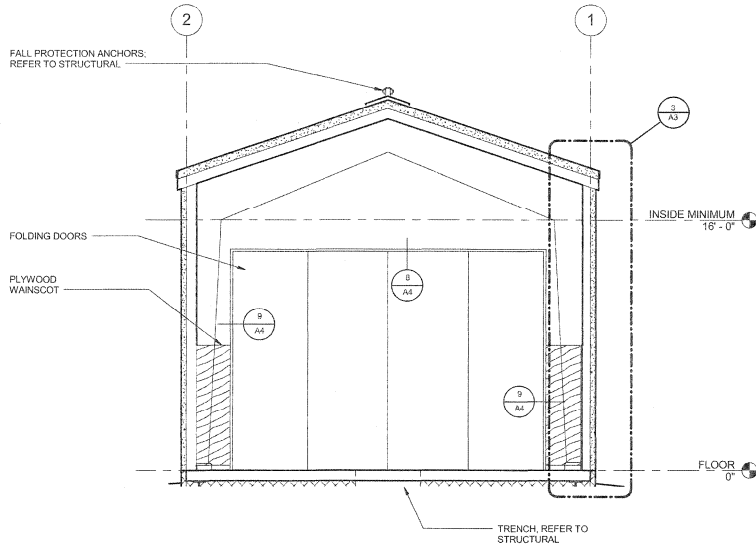


1 CROSS SECTION  
A3 1/4" = 1'-0"

0 2 4 6  
 22X34 SHEET 11X17 SHEET  
 1/4" = 1'-0" 1/8" = 1'-0"

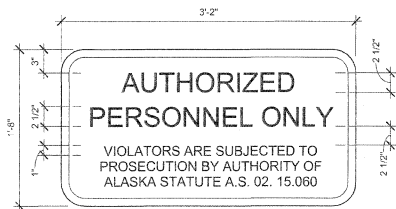

NOTE: PROVIDE SIGN FOR EACH SREB. SIGNS SHALL BE SUBSIDIARY TO PAY ITEM S-142

2 SIGN MESSAGE  
A3 1 1/2" = 1'-0"

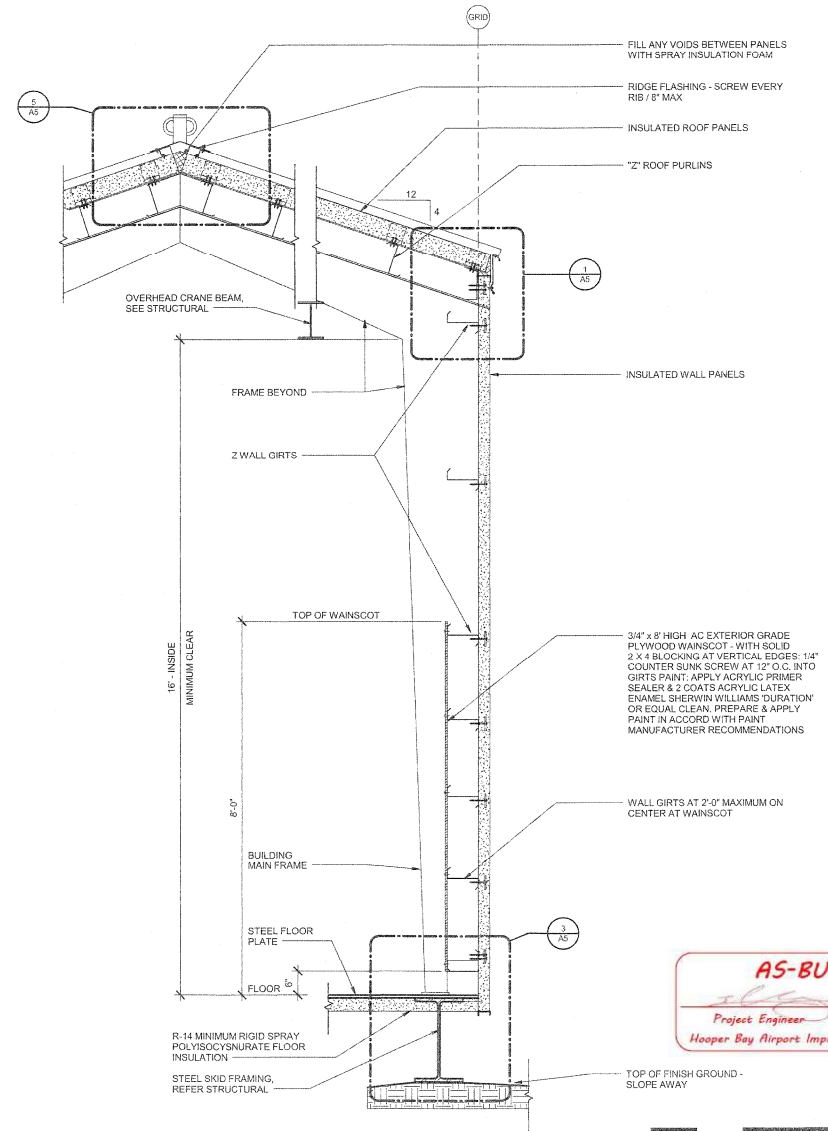

3 TYPICAL WALL SECTION  
A3 3/4" = 1'-0"

0 1 2 3 4  
 22X34 SHEET 11X17 SHEET  
 3/4" = 1'-0" 3/8" = 1'-0"



PLANS DEVELOPED BY:  
 MOD ARCHITECTS  
 PROJ. N/A 2010039.09


BY	DATE	REVISION

STATE OF ALASKA  
 DEPARTMENT OF TRANSPORTATION  
 AND PUBLIC FACILITIES  
 CENTRAL REGION


HOOPER BAY, AIRPORT  
 HOOPER BAY, ALASKA  
 AIRPORT IMPROVEMENTS  
 PROJECT No. 59276  
 AIP No. 3-02-0424-008-2014  
 BUILDING SECTIONS

DATE:  
 04/04/2015  
 SHEET:  
 A3 of A5  
 AS-BUILT SHEET


**AS-BUILT**  
 Project Engineer: *[Signature]* Date: 3/1/18  
 Hooper Bay Airport Improvements 57419

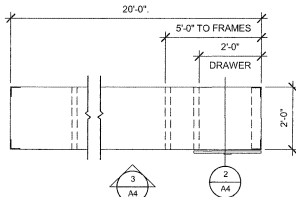

**1 WORK BENCH PLAN**  
A4 1/2" = 1'-0"

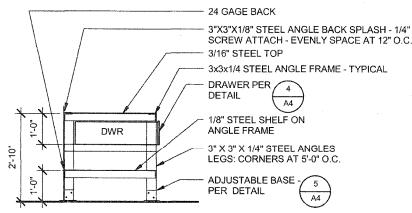

**2 WORK BENCH SECTION**  
A4 1/2" = 1'-0"

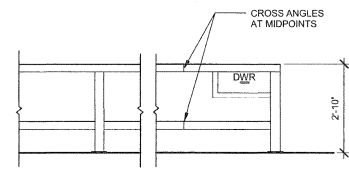


**3 WORK BENCH FRONT**  
A4 1/2" = 1'-0"


## WORK BENCH SPECIFICATIONS

INSTALL WHERE INDICATED ON FLOOR PLAN


- FRAME:** 3 x 3 x 1/4" STEEL ANGLES - WELD 3/16" FILLET AT CONNECTIONS
- TOP:** 3/16" STEEL PLATE
- SHELF:** 1/8" STEEL PLATE
- BACK:** 24 GAGE STEEL SHEET
- DRAWER:** BOTTOM AND SIDES: 16 GAGE GALVANIZE SHEET STEEL BEND OR WELDED - HEM TOP EDGES  
PULL: 6x5/16" WIRE; STANLEY 4486 OR EQUAL
- EDGES:** SMOOTH EDGES BY GRINDING - FREE FROM SHARP SURFACES
- FINISH:** SHOP APPLY: SOLVENT CLEAN POWER GRIND OR GRIT BLAST CLEAN, PRIME AND EPOXY ENAMEL PAINT

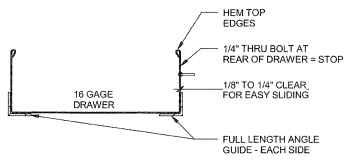


**4 WORK BENCH DRAWER**  
A4 1 1/2" = 1'-0"

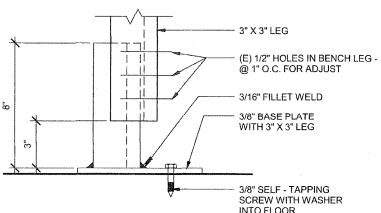


**5 WORK BENCH LEG**  
A4 3" = 1'-0"

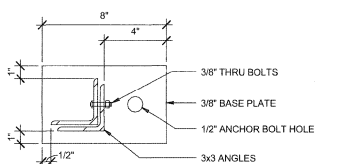


**6 WORK BENCH LEGS BASE PLATE**  
A4 3" = 1'-0"

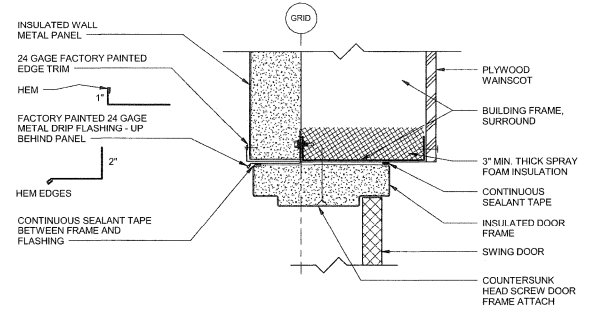

**7 HINGED DOOR HEAD - JAMB SIMILAR**  
A4 3" = 1'-0"

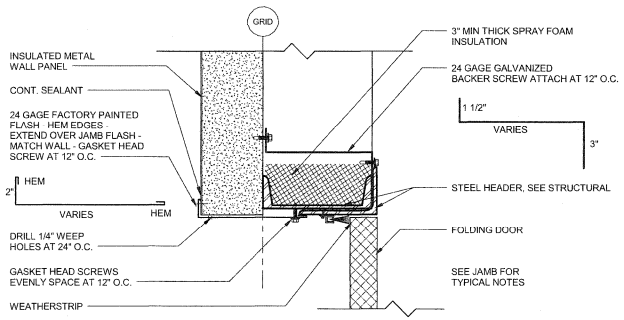

**8 FOLDING DOOR HEAD**  
A4 3" = 1'-0"

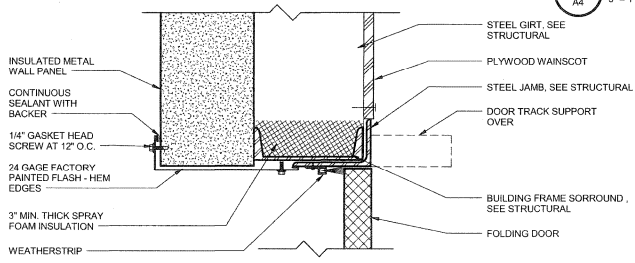

**9 FOLDING DOOR JAMB**  
A4 3" = 1'-0"




PLANS DEVELOPED BY:  
MCG ARCHITECTS  
PROJ. NO. 2010039.09




			<b>STATE OF ALASKA</b>		<b>HOOPER BAY, AIRPORT</b>		DATE: 04/04/2015
			<b>DEPARTMENT OF TRANSPORTATION</b>		HOOPER BAY, ALASKA		
			<b>AND PUBLIC FACILITIES</b>		AIRPORT IMPROVEMENTS		SHEET:
			<b>CENTRAL REGION</b>		PROJECT No. 59276		A4 of A5
					AIP No. 1-07-007-006-2014		AS-BUILT SHEET
BY	DATE	REVISION			DETAILS		

Drawn By: [Signature]  
 Checked By: [Signature]  
 Date: 4/7/2015 15:23:19 PM  
 File Path: [Path]  
 Project: [Project Name]




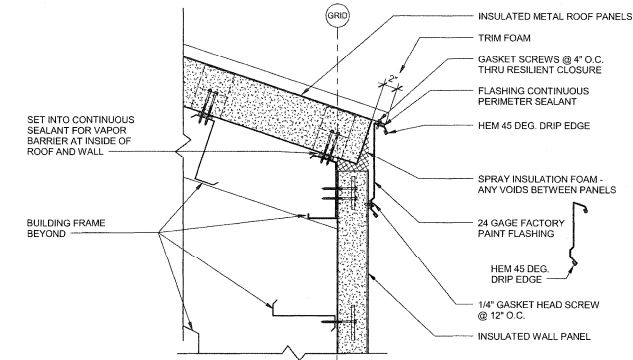


**1 ROOF EAVES**  
 A5 1 1/2" = 1'-0"

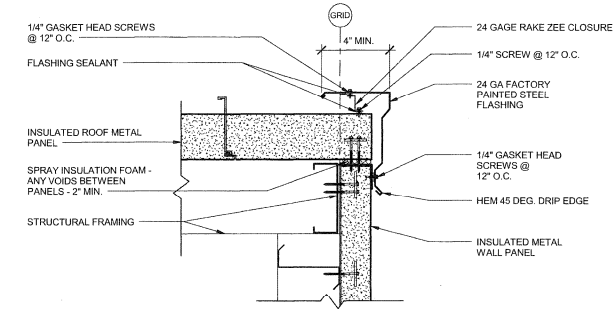


**2 ROOF RAKE**  
 A5 1 1/2" = 1'-0"

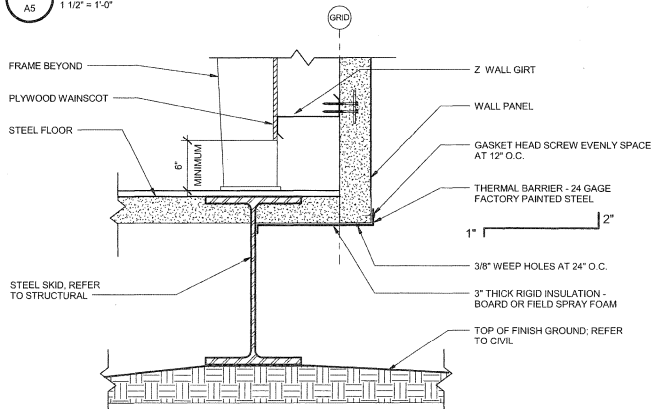



**3 BASE DETAIL**  
 A5 1 1/2" = 1'-0"

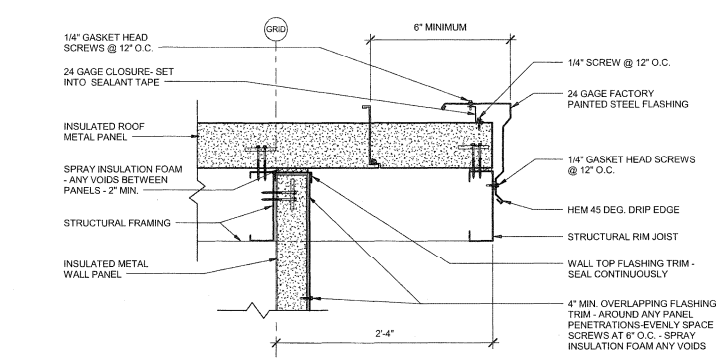


**4 ROOF OVER AT OVERHEAD DOOR**  
 A5 1 1/2" = 1'-0"

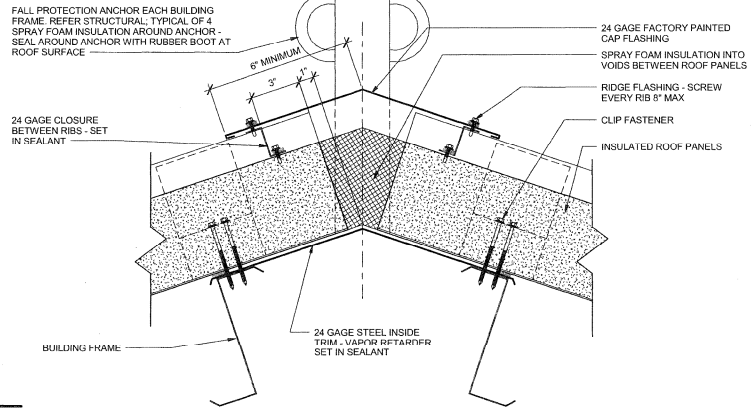

**5 RIDGE**  
 A5 3" = 1'-0"

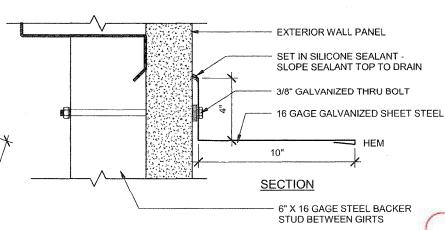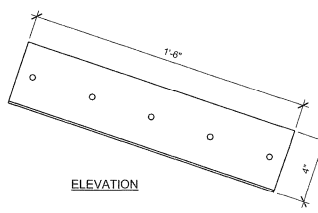

**7 LIGHT ICE DEFLECTOR DETAIL**  
 A5 3" = 1'-0"

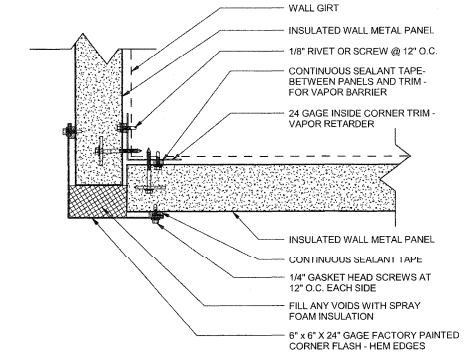

**6 CORNER AT WALL PANEL**  
 A5 3" = 1'-0"



PLANS DEVELOPED BY:  
 MCG ARCHITECTS  
 PROJ. NO. 2310039.09

BY	DATE	REVISION

**STATE OF ALASKA**  
**DEPARTMENT OF TRANSPORTATION**  
**AND PUBLIC FACILITIES**  
**CENTRAL REGION**






**HOOPER BAY, AIRPORT**  
 HOOPER BAY, ALASKA  
 AIRPORT IMPROVEMENTS  
 PROJECT No. 59276  
 AIP No. 3-02-0424-006-2014

**AS-BUILT**  
 Project Engineer: *[Signature]* Date: 3/1/18  
 Hooper Bay Airport Improvements 57419




DATE: 04/04/2015  
 SHEET: A5 of A5  
 AS-BUILT SHEET



Date Revised: 4/12/2015, 10:17 AM  
 Drawn By: [Signature]  
 Checked By: [Signature]  
 Project Name: Hooper Bay Airport Improvements 57419  
 Project No: 3-02-0126-006-2014  
 Sheet No: S2 of S4

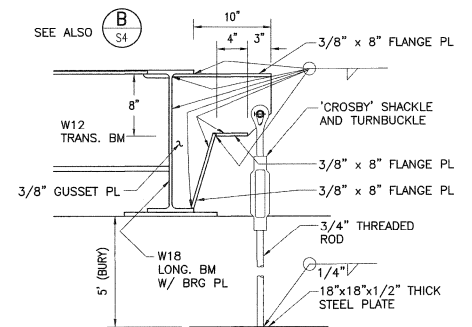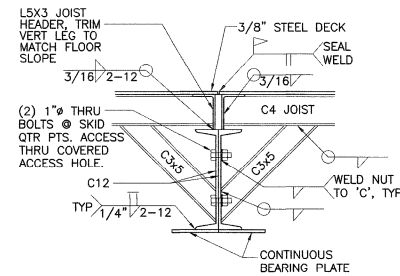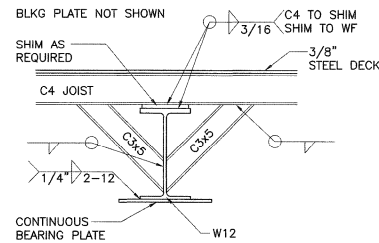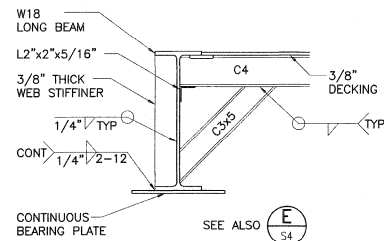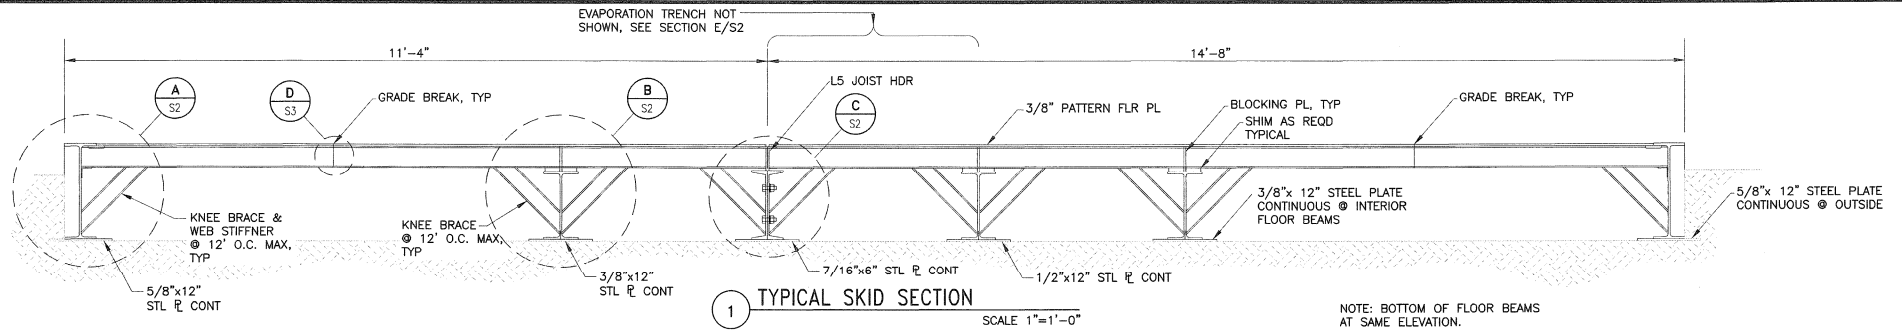

- UNOTES:
1. CHANCE HELICAL WITH 2 7/8" SHAFT, 10" HELIX WITH 8" BURY MAY BE USED IN LIEU OF TURNBUCKLE/ SHACKLE DETAIL
  2. BELOW GRADE STEEL SHALL BE HOT DIP GALV AFTER FABRICATION

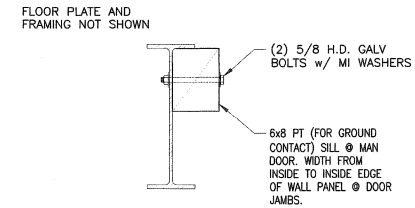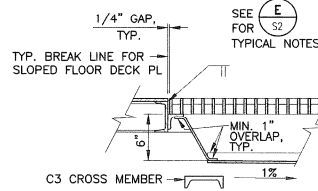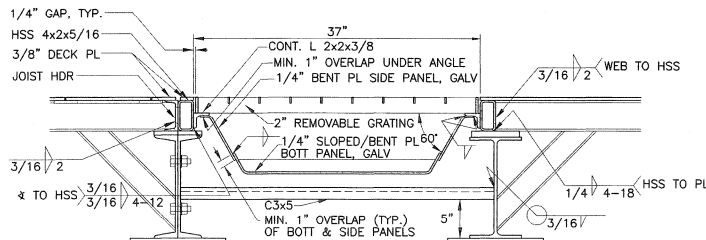

BY	DATE	REVISION


STATE OF ALASKA  
 DEPARTMENT OF TRANSPORTATION  
 AND PUBLIC FACILITIES  
 CENTRAL REGION

HOOPER BAY AIRPORT  
 SNOW REMOVAL EQUIPMENT BUILDING  
 PROJECT No. 57419  
 AIP No. 3-02-0126-006-2014  
 STRUCTURAL DETAILS


DATE: 04/03/2015  
 SHEET: S2 OF S4

**AS-BUILT**  
 Project Engineer: [Signature] Date: 3/1/18  
 Hooper Bay Airport Improvements 57419


Date Received: 4/12/2015, 9:12 AM  
 Project Name: SNOW REMOVAL EQUIPMENT BUILDING  
 Project No.: 57419  
 Project Location: HOOPER BAY AIRPORT, ALASKA  
 Project Description: SNOW REMOVAL EQUIPMENT BUILDING  
 Project Status: IN PROGRESS  
 Project Manager: J. J. JENSEN  
 Project Engineer: J. J. JENSEN  
 Project Designer: J. J. JENSEN  
 Project Checker: J. J. JENSEN  
 Project Approver: J. J. JENSEN  
 Project Date: 4/12/2015

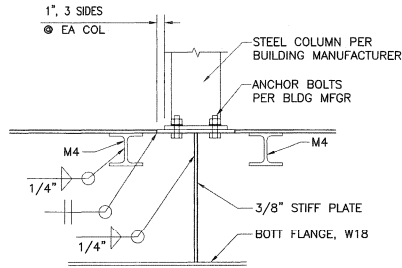


**A COLUMN BEARING DETAIL**  
SCALE 1-1/2"=1'-0"

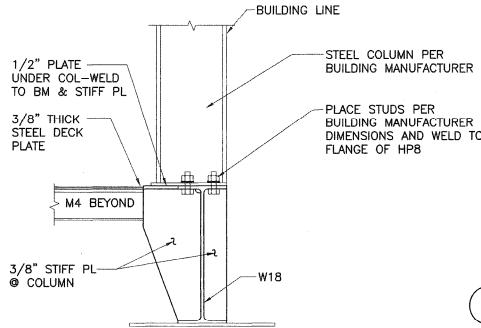


**B COLUMN BEARING DETAIL**  
SCALE 1-1/2"=1'-0"

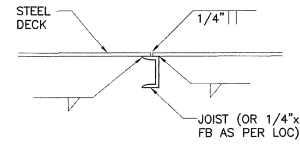


**C SECTION @ DECK PLATE JOINT**  
SCALE 1-1/2"=1'-0"

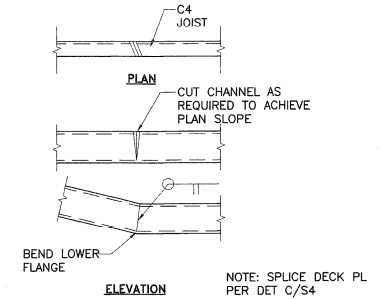


**D JOIST CUT & WELD @ SLOPE CHANGES DET**  
SCALE 1-1/2"=1'-0"

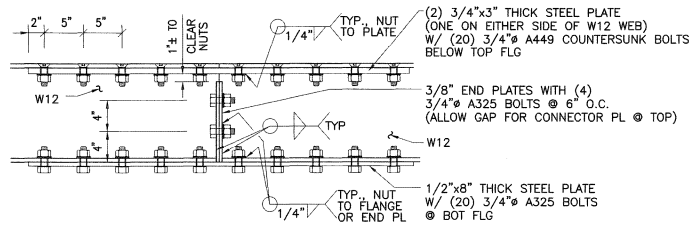


**E TYPICAL SPLICE DETAIL**  
SCALE 1-1/2"=1'-0"

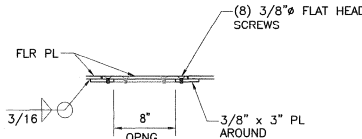


**F FLOOR ACCESS HOLE DETAIL**  
SCALE 1-1/2"=1'-0"

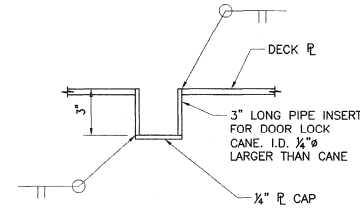

**H BIFOLD DOOR BRACE**  
SCALE 3"=1'-0"

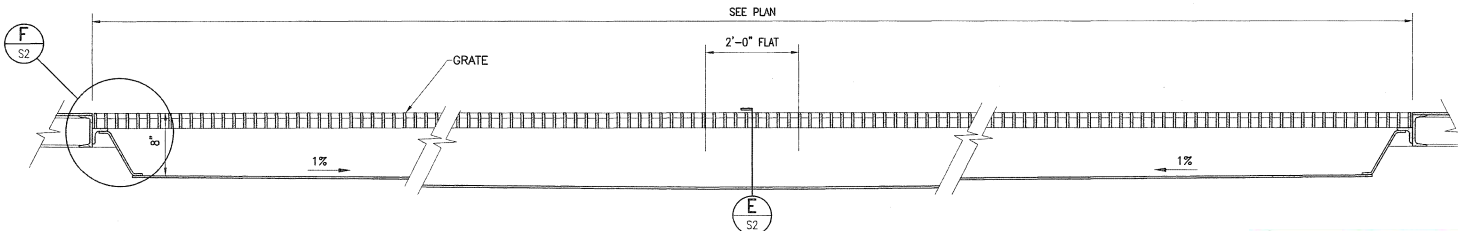

**G LONGITUDINAL SECTION @ EVAPORATION TRENCH**  
SCALE 1-1/2"=1'-0"

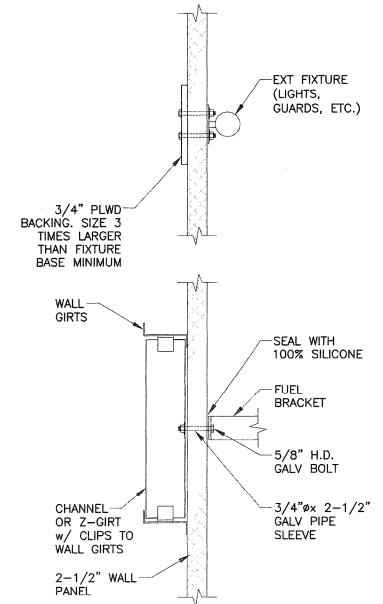

**I TYP WALL MOUNT DETAILS**  
SCALE 1-1/2"=1'-0"



PLANS DEVELOPED BY: J. J. JENSEN

**AS-BUILT**  
 Project Engineer: J. J. JENSEN  
 Date: 3/1/18  
 Hooper Bay Airport Improvements 57419

BY	DATE	REVISION

STATE OF ALASKA  
 DEPARTMENT OF TRANSPORTATION  
 AND PUBLIC FACILITIES  
 CENTRAL REGION

HOOPER BAY AIRPORT  
 SNOW REMOVAL EQUIPMENT BUILDING  
 PROJECT No. 57419  
 AIP No. 3-02-0126-006-2014  
 STRUCTURAL DETAILS

DATE: 04/03/2015  
 SHEET: S3 OF S4





(B) LONGITUDINAL/TRANS BEAM CONN. SCALE 1-1/2"=1'-0"



WT TO W. 5/16"

WT4X17.5

W18 TOW BEAM SEE G S5

SPUCE PL SEE E S4

SECTION A-A

W12 TRANS BEAM

3/8" PL STIFF, TYP.

C12 LONG. BMS

1/4" BRG PL BELOW C12s

FIELD SPICES PER E S3

IF 3/8" PL REQD

16"

TYP NUT TO W12

TYP 3/8" PL STIF (TYP EACH SIDE)

WELD ALL NUTS TO WEB

1/4"

TOW BAR DETAIL

SECTION B-B

TS4x4x1/4"

1/2"x12"x8" PLATE

(4) 3/4" BOLTS

1 1/2" 8" 1 1/2"

5 1/4"

CL TS


1" 1"

SCALE 1-1/2"=1'-0"


N.T.S.

1" FLANGE COPE  
 1/4"  $\nabla$   
 W12 TRANSVERSE BM  
 3"  
 3'  
 3/8"  $\nabla$   
 END PL BEYOND  
 CJP  
 C12 BEYOND  
 COPE C12 TO CLR  
 W12 & SPLICE PL  
 W18  
 1/2"x6" FB  
 PAD EYE  
 SEE C/S5  
 TS BRACE  
 @ SKID JOINT  
 3/8" PL EA SIDE WT/W18  
 WITH (3) 1 1/8"  $\phi$  BOLTS  
 1/2"x10"x18" SKID PL


**G** DETAIL SCALE 1-1/2"=1'-0"

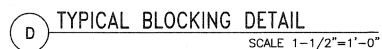

**D TYPICAL BLOCKING DETAIL**  
SCALE 1-1/2"=1'-0"

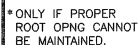



**(E) TYPICAL JOIST CONNECTION**  
SCALE 1-1/2"=1'-0"

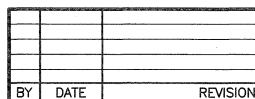

STATE OF ALASKA  
DEPARTMENT OF TRANSPORTATION  
AND PUBLIC FACILITIES  
CENTRAL REGION

**HOOPER BAY AIRPORT**  
HOOPER BAY, ALASKA  
SNOW REMOVAL EQUIPMENT BUILDING  
PROJECT No. 57419  
AIP No. 3-02-0126-006-2014  
STRUCTURAL DETAILS

DATE: 04/03/2015  
SHEET: S4 OF S4

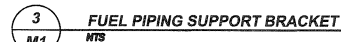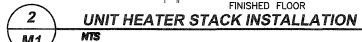

NOTE: FURNISH AND INSTALL MAKES AND MODELS  
CITED HERE OR IN THE SPECIFICATIONS OR APPROVED

---




NOTE: WORK SHALL APPLY FOR BOTH HEATED SREB BUILDINGS.

**AS-BUILT**

 3/1/18

Project Engineer Date


Hooper Bay Airport Improvements 57419

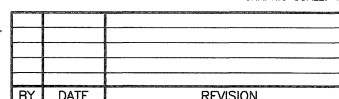

**HOOPER BAY AIRPORT**  
HOOPER BAY, ALASKA  
SNOW REMOVAL EQUIPMENT BUILDING  
AIP\_NUMBER: 3-02-0126-006-2014  
  
MECHANICAL PLAN AND DETAILS


DATE:	6/11/2015
SHEET:	M1 OF M2
AS-BUILT SHEET:	

State of Alaska  
 Department of Transportation  
 Project Name: Hooper Bay Airport Improvements 57419  
 Project Number: 3-02-0126-006-2014  
 Date: 6/11/2015  
 Drawn By: [Signature]  
 Checked By: [Signature]

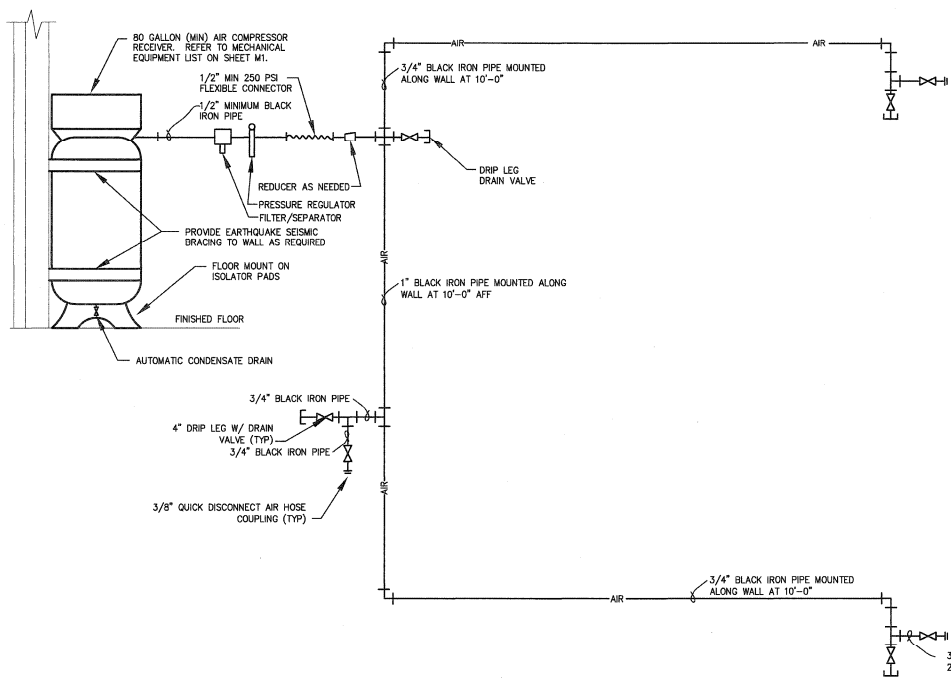


**1**  
**M2** **COMPRESSED AIR SYSTEM PIPING SCHEMATIC**  
 NTS

NOTE: DETACHABLE HOSE REEL (SEE MECHANICAL EQUIPMENT LIST ON SHEET M1) TO BE UTILIZED AT ANY OUTLET.

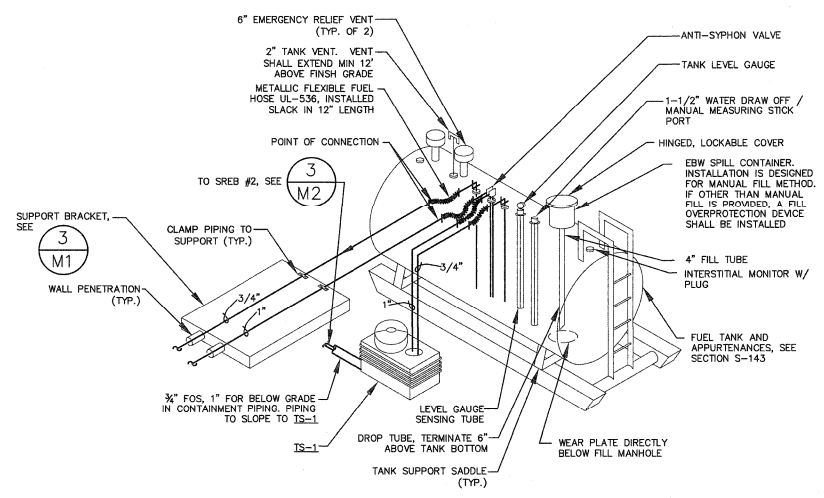

**2**  
**M2** **FUEL OIL TANK DETAIL**  
 NTS

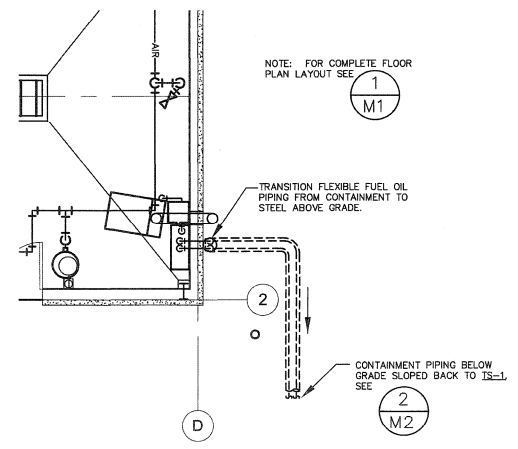

**3**  
**M2** **SREB #2 PARTIAL PLAN**  
 1/8" = 1'-0"

PLAN PREPARED BY MBA CONSULTING ENGINEERS, INC.

**AS-BUILT**  
 Project Engineer: [Signature] Date: 3/1/18  
 Hooper Bay Airport Improvements 57419



BY	DATE	REVISION

STATE OF ALASKA  
 DEPARTMENT OF TRANSPORTATION  
 AND PUBLIC FACILITIES  
 CENTRAL REGION

HOOPER BAY AIRPORT  
 HOOPER BAY, ALASKA  
 SNOW REMOVAL EQUIPMENT BUILDING  
 AIP NUMBER: 3-02-0126-006-2014  
 COMPRESSED AIR SCHEMATIC

DATE: 6/11/2015  
 SHEET: M2 OF M2  
 AS-BUILT SHEET:

DATE:  
4/3/2015  
SHEET:  
E1 OF E4  
AS-BUILT SHEET



### PANEL: C

PROJECT: SINGLE BAY SREB  
LOCATION: LUGS ☐ SURF ☐ THRUFEED LGS ☐ SUBFEED BKR ☐  
CB ☐ FLSH ☐ SHNT TRP ☐ ISO GRND BAR ☐  
CB ☐ SFBD LGS ☐ SOLID NEUTRAL ☐

120/240 VOLTS		1 PH	3 WIRE	200 AMP	22,000 (1) AIC
CIRCUIT DESCRIPTION	KVA	AMP	CKT	CKT	KVA
PANEL G	5.83	50	1	2	30/1
50 AMP 240 VOLT RECEPTACLE	9.6	50	5	6	30
NEMA 6-50R		50	7	8	30
NEMA 5-20 RECEPTACLES	0.72	20	11	12	20/1
NEMA 5-20 RECEPTACLES	0.54	20	11	12	20/1
AIR COMPRESSOR - 3 HP	4.78	50	13	14	20/1
SPACE		2	15	16	20/1
SPACE		20	17	18	20/1
SPACE		20	19	20	20/1
SPACE		21	22	23	20/1
SPACE		23	24	25	20/1
SPACE		25	26	27	20/1
SPACE		27	28	29	20/1
SPACE		29	30	31	20/1
CONNECTED LOAD:	24.53	KVA	102.2	A	REMARKS:
DEMAND LOAD:	24.53	KVA	102.2	A	1. PROVIDE SEPARATE NEUTRAL AND EQUIPMENT GROUND BARS
DEMAND + CONT.	25.81	KVA	107.6	A	2. PROVIDE SEPARATE NEUTRAL AND EQUIPMENT GROUND BARS
DATE:					3. PROVIDE 200/2 MAIN CB
REV:					


### PANEL: G

PROJECT: SINGLE BAY SREB  
LOCATION: LUGS ☐ SURF ☐ THRUFEED LGS ☐ SUBFEED BKR ☐  
CB ☐ FLSH ☐ SHNT TRP ☐ ISO GRND BAR ☐  
CB ☐ SFBD LGS ☐ SOLID NEUTRAL ☐

120/240 VOLTS		1 PH	3 WIRE	100 AMP	22,000 AIC
CIRCUIT DESCRIPTION	KVA	AMP	CKT	CKT	KVA
LIGHTING	1.28	20	1	1	30/1
LIGHTING	0.29	20	1	3	7/5
PADBLE FAN & UNIT HEATER	0.75	15	1	5	20/1
1 1/2 HP FUEL PUMP AND DISPENSER	0.83	20	1	9	10/15
FUEL PUMP STOP/DISCONNECT	0.1	15	1	11	12/15
SPACE		13	14	20	1.0
SPACE		15	16		
CONNECTED LOAD:	5.83	KVA	24.3	A	REMARKS:
DEMAND LOAD:	5.83	KVA	24.3	A	1. PROVIDE SEPARATE NEUTRAL AND EQUIPMENT GROUND BARS
DEMAND + CONT.	6.47	KVA	26.9	A	2. VERIFY CB REQUIREMENTS FOR FUEL DISPENSER
DATE:					
REV:					

#### NOTES:

- (1) PROVIDE MULTIPOLAR CIRCUIT BREAKERS OR CIRCUIT BREAKERS WITH HANDLE TIES, AS REQUIRED FOR COMPLIANCE WITH NEC 210.4(B), WHEREVER FIELD WIRING RESULTS IN MULTI-WIRE BRANCH CIRCUITS.

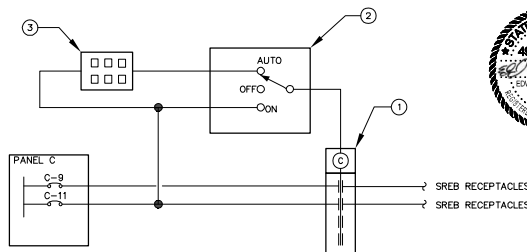

### 1 RECEPTACLE CONTROL DIAGRAM

NTS

EQUIPMENT:

- 4-POLE (2 SPARE) 30 AMP, ELECTRICALLY HELD, 120VAC COIL, CONTACTOR, SCHNEIDER 8903L SERIES OR AS APPROVED
- HOA KEYED SWITCH (SHOWN IN THE AUTO POSITION). LOCATED IN CONTACTOR.
- 24 HOUR PROGRAMMABLE TIMER, LOCKABLE, BATTERY BACKUP, INTER MATIC GMX QT-1-120 OR AS APPROVED.

PLAN PREPARED BY MBA CONSULTING ENGINEERS, INC.



LEGEND				
FIXTURE	DESCRIPTION	MOUNTING HEIGHT	LAMP SIZE/TYPE	REMARKS
A/150	CEILING MOUNT WITH POWER HOOK AND SAFETY CHAIN, 12,000 LUMENS, WIDE DISTRIBUTION, NO SHIELDING, 120 VOLT, 70 CRT, 4000K CCT. FIXTURE STANDARD FINISH TO MATCH BUILDING FINISH AS CLOSELY AS POSSIBLE. SUITABLE FOR -40F, DAMP LOCATION LISTED. LITHONIA 1BL-12L-ND-LP740DLC OR APPROVED EQUAL.	16'-0"	LED	
B/75	WALL MOUNT AREA LIGHT, POLYCARBONATE REFRACTOR, 120-VOLT, 5100K CCT, 5337 LUMENS. PROVIDE INTEGRAL PHOTO-ELECTRIC CELL WHERE NOTED ON PLANS. FIXTURE STANDARD FINISH TO MATCH BUILDING FINISH AS CLOSELY AS POSSIBLE. UL LISTED FOR WET LOCATION. HUBBELL PAUL-3-30LU-5K-BZ OR APPROVED EQUAL.	2 FEET BELOW ROOF STRUCTURE	LED	
E/60	EMERGENCY EGRESS LIGHT, NICKEL-CADMIUM BATTERY, 12V, -40°C RATING, INDUSTRIAL LIGHTING UNIT, UL LISTED FOR WET LOCATION. SURVIVE-ALL SV SERIES CATALOG NO. W-12SV24N-2-LJ-D-OW4, OR APPROVED EQUAL.	8'-0"	LED	
(1)	NOTE SYMBOL - NUMBER INDICATED			
1	SINGLE POLE SWITCH, LIGHTED TOGGLE (LIGHT ON WITH LOAD OFF)	48"		
3	3-WAY SWITCH, LIGHTED TOGGLE (LIGHT ON WITH LOAD OFF)	48"		
T	SINGLE POLE MANUAL MOTOR STARTER SWITCH W/THERMAL OVERLOAD ELEMENT	48"		
WP	WEATHERPROOF SWITCH	48"		
WP & SP	DOUBLE POLE HAND-OFF-AUTO SWITCH WITH SPEED CONTROL	48"		
WP	WEATHERPROOF JUNCTION BOX			
	CIRCUIT BREAKER PANEL, SEE PANEL SCHEDULE	6'-6" TO TOP		
	CIRCUIT BREAKER (CB)			
	ELECTRICAL CIRCUIT			
	HOME RUN TO CIRCUIT PANEL WITH PANEL AND BREAKER NUMBER			
	GROUND ELECTRODE SYSTEM CONNECTION			
D	DUPLEX OUTLET, GFCI, NEMA 5-20R	48"		
A	RECEPTACLE, 30 AMP, 120V, NEMA 5-30R	48"		PROVIDE MATCHING ANGLE PLUG
B	RECEPTACLE, 50 AMP, 240V, NEMA 6-50R	48"		PROVIDE MATCHING ANGLE PLUG
D	DISCONNECT SWITCH, 60A, 2P, S/N, 240V	5'-6"		
F	FAN JUNCTION BOX			
G	MOTOR WITH HORSEPOWER INDICATED			
I	GENERATOR INLET, NEMA L14-30 IN NEMA-3R ENCLOSURE	48"		
USE	UNDERGROUND ELECTRICAL			
	LOW VOLTAGE CKT.			
RSC	RIGID STEEL CONDUIT			
LFMC	LIQUID TIGHT FLEXIBLE METAL CONDUIT			
BCG	BARE COPPER GROUNDING CONDUCTOR			
AF	ABOVE FINISHED FLOOR			

#### SREB GENERAL NOTES:

- THE WORK SHOWN ON THIS DRAWING IS APPLICABLE TO SREB #1.
- THE WORK SHOWN ON THIS DRAWING IS APPLICABLE TO SREB #2, EXCEPT FOR THE FOLLOWING:
  - PANEL C:
    - PANEL DEMAND + CONT. = 22.99 KVA, 95.8 AMPS @ 120/240V.
  - THE FOLLOWING CIRCUIT BREAKERS ARE NOT REQUIRED IN PANEL G (CONVERT THEM TO "SPARE"):
    - LEAK ALARM PANEL (G-14)
    - FUEL PUMP AND DISPENSER (G-9).
    - FUEL PUMP STOP/DISCONNECT (G-11).
    - PANEL DEMAND + CONT. = 4.29 KVA, 17.9 AMPS @ 120/240V.

AS-BUILT  
Project Engineer: [Signature] Date: 3/1/18  
Hoopers Bay Airport Improvements 57419


EWC	5-24-16	RECEPTACLE CONTROL
BY	DATE	REVISION

STATE OF ALASKA  
DEPARTMENT OF TRANSPORTATION  
AND PUBLIC FACILITIES  
CENTRAL REGION

HOOPER BAY AIRPORT  
HOOPER BAY, ALASKA  
SNOW REMOVAL EQUIPMENT BUILDING  
AIP NUMBER: 3-02-0126-006-2014  
ELECTRICAL LEGEND AND SCHEDULES

DATE: 4/3/2015  
SHEET: E1 OF E4  
AS-BUILT SHEET:


Date Received: 3/27/2015, 11:22 AM  
 Drawn By: KSP  
 Checked By: KSP  
 File Path and Name: Z:\14014185 - Hooper Bay SREB - Airfield Improvements\14014185\_E2.dwg

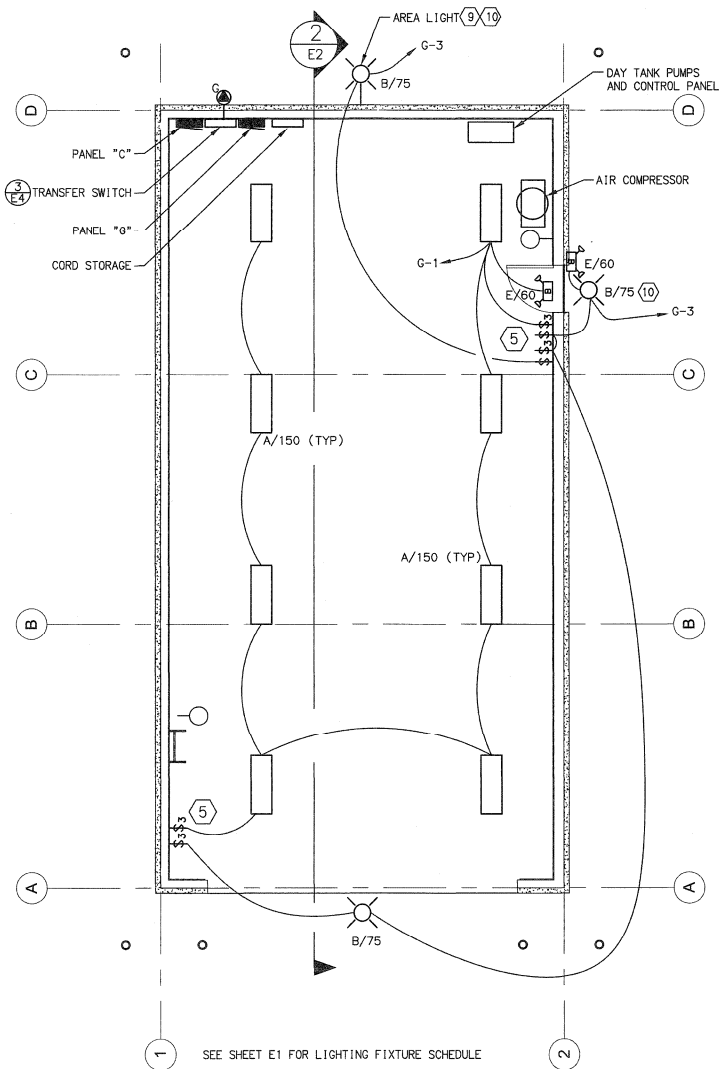

**1**  
**E2** **LIGHTING PLAN**  
 1/8" = 1'-0"

## ELECTRICAL NOTES - SHEETS E2 & E3

- ① 120-VOLT POWER FOR COMPRESSOR CRANKCASE HEATER AND AUTOMATIC CONDENSATE DRAIN CONTROL TO BE CONNECTED TO NEMA-5-20 RECEPTACLE NEXT TO COMPRESSOR.
- ② ALL CONDUITS IN THE BUILDING, PASSING THROUGH THE ZONE FROM THE FLOOR TO 1.5' ABOVE THE FLOOR, SHALL BE RMC AND SHALL HAVE A SEAL FITTING LOCATED 18" MINIMUM ABOVE THE FLOOR. THE BUILDING ELECTRICAL INSTALLATION SHALL COMPLY WITH NEC ARTICLE 511 "COMMERCIAL GARAGES, REPAIR AND STORAGE".
- ③ NOT USED.
- ④ INSTALL CONTINUOUS #3/0 AWG BGC GROUND RING, BURY DEPTH 30". GROUNDING ELECTRODE SYSTEM: BOND TOGETHER GROUND RODS, THE BUILDING STEEL FRAME, BUILDING STEEL FLOOR, AND THE GROUND RING WITH #2 AWG CONDUCTORS. AT THE SERVICE ENTRANCE, BOND #6 AWG CONDUCTOR TO GROUNDING ELECTRODE SYSTEM FOR CONNECTION TO BUILDING DISCONNECT. SEE AIRFIELD LIGHTING DRAWINGS.
- ⑤ SWITCHES FOR LIGHT FIXTURES-A/150 & B/75 TO HAVE LOCATOR LIGHTS IN TOGGLE.
- ⑥ FOR ALL EXTERIOR WIRING AND INTERIOR WIRING BELOW 10 FT ABOVE FINISH FLOOR, USE RIGID STEEL CONDUIT. IMC AND EMT CONDUIT MAY BE USED 10 FT A.F.F. WITHIN THE BUILDING ENVELOPE.
- ⑦ NOT USED.
- ⑧ NOT USED.
- ⑨ LOCATE FIXTURE TO ILLUMINATE THE FUEL DISPENSING AREA AND ELECTRICAL EQUIPMENT BUILDING. LOCATE TO AVOID CONFLICT WITH UNIT HEATER EXHAUST AND OTHER ITEMS.
- ⑩ MOUNT 2 FEET BELOW ROOF STRUCTURE. PROVIDE WITH MOTION SENSOR (WATSTOPPER EW-200-120-G OR APPROVED EQUAL) AND INTEGRAL PHOTOCELL. SEE DETAIL 4/E4 FOR CONTROL DIAGRAM.
11. PROVIDE SLACK LOOP ADEQUATE TO ACCOMMODATE MOVEMENT OF 12 INCHES IN ANY DIRECTION WHEN TRANSITIONING TO UNDERGROUND CONDUIT.
12. PENETRATIONS THROUGH EXTERIOR WALL SHALL BE BELOW SERVED EQUIPMENT.

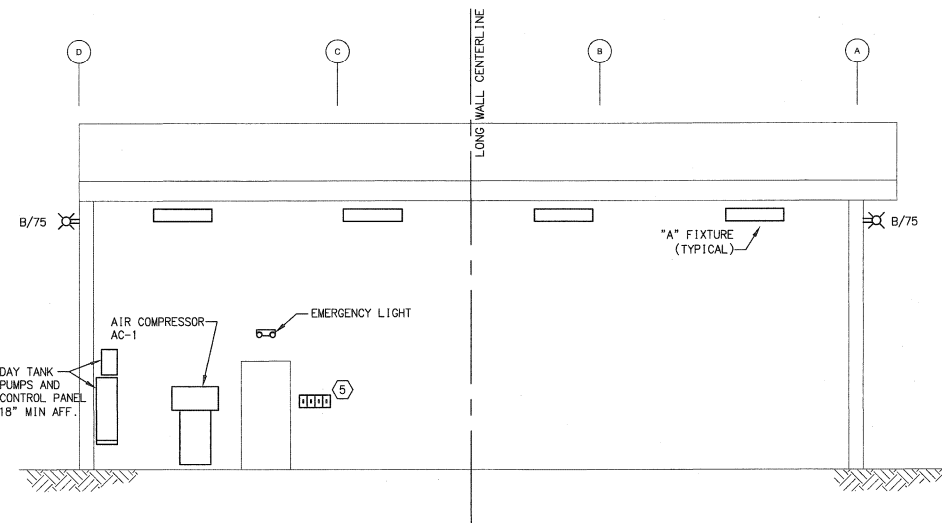

**2**  
**E2** **INTERIOR ELEVATION**  
 1/8" = 1'-0"

4' 0 4' 8' 12'  
 GRAPHIC SCALE: 1/8" = 1'-0"

### SREB GENERAL NOTES:

1. THE WORK SHOWN ON THIS DRAWING IS APPLICABLE TO SREB #1 AND TO SREB #2.

PLAN PREPARED BY MBA CONSULTING ENGINEERS, INC.

**AS-BUILT**  
 Project Engineer: *[Signature]* Date: 3/1/18  
 Hooper Bay Airport Improvements 57419



BY	DATE	REVISION


STATE OF ALASKA  
 DEPARTMENT OF TRANSPORTATION  
 AND PUBLIC FACILITIES  
 CENTRAL REGION

HOOPER BAY AIRPORT  
 HOOPER BAY, ALASKA  
 SNOW REMOVAL EQUIPMENT BUILDING  
 AIP NUMBER: 3-02-0126-006-2014  
 ELECTRICAL LIGHTING PLAN

DATE: 4/3/2015  
 SHEET: **E2** OF **E4**  
 AS-BUILT SHEET:



- 4' 0 4' 8' 12  
GRAPHIC SCALE: 1/8" = 1'-0"

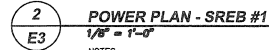


- |                 |          |
|-----------------|----------|
| DATE:           | 4/3/2015 |
| SHEET:          | E3 OF E4 |
| AS-BUILT SHEET: |          |


3/27/2015 11:22 AM  
Project: Hooper Bay Airport Improvements 57419  
Sheet: E4 of E4  
Title: SNOW REMOVAL EQUIPMENT BUILDING  
Author: Michael J. Foy  
Checked By: ECR

# DETAIL NOTES:

- ① NOT USED.
  - ② 60-AMP 250-VOLT NON-FUSED TWO-POLE DOUBLE-THROW TRANSFER SWITCH, SQUARE-D CATALOG NO. DTU222 OR APPROVED EQUAL.
  - ③ SEAL CONDUIT PENETRATION ON INSIDE AND OUTSIDE BETWEEN THE INTERIOR AND EXTERIOR OF THE BUILDING WITH DUX SEAL.
  - ④ PROVIDE A 20-FOOT "ARCTIC" POWER CORD CONTAINING THREE #8 AWG POWER CONDUCTORS AND ONE #10 AWG GROUND CONDUCTOR WITH A CS63-64C\* CONNECTOR ON ONE END AND A CS63-65C\* PLUG ON THE OTHER. PROVIDE THE FOLLOWING 36-INCH LONG ADAPTER CORDS:  
(A) 1-4C #10 POWER CORD WITH A CS63-64C\* CONNECTOR ON ONE END AND A NEMA-L14-30 PLUG ON THE OTHER.  
(B) 1-4C #12 POWER CORD WITH A CS63-64C\* CONNECTOR ON ONE END AND A NEMA-L14-20 PLUG ON THE OTHER. PROVIDE WALL CABINET NEXT TO PANEL-G TO STORE THE CORDS.
  - ⑤ MOUNT A CS63-75C\* (MALE) GENERATOR FLANGED INLET IN A NEMA-3R GALVANIZED/PAINTED ENCLOSURE WITH THE INLET 48 INCHES ABOVE THE FLOOR LEVEL - MIDWEST ELECTRIC PRODUCTS CAT. NO. UDSON OR APPROVED EQUAL (OTHER ACCEPTED MANUFACTURERS - GE, CROUSE-HINDS).
- \* CALIFORNIA STANDARD 125/250-VOLT, 3-POLE, 4-WIRE, NON-NEMA, 50-AMP WIRING DEVICE, LEVITON CATALOG # AS SHOWN, OR APPROVED EQUAL (OTHER ACCEPTED MANUFACTURERS - CROUSE-HINDS, APPETON).

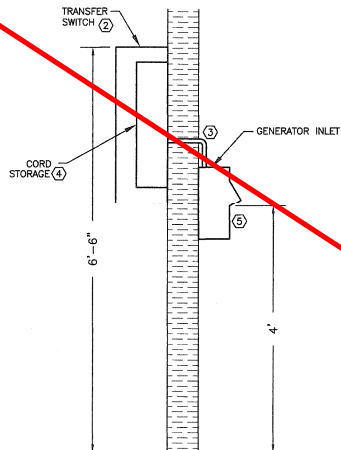


3  
E4  
PANEL "G" - GENERATOR INLET ELEVATION  
NTS

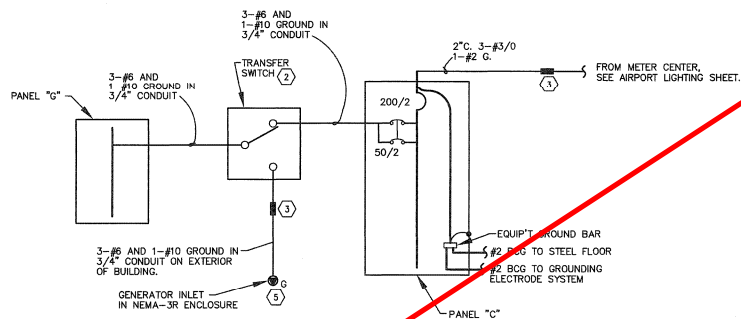

4  
E4  
POWER ONE LINE DIAGRAM  
NTS


NOTE: REFER TO AIRPORT LIGHTING SHEETS FOR METER PANEL LOCATION AND DETAIL.

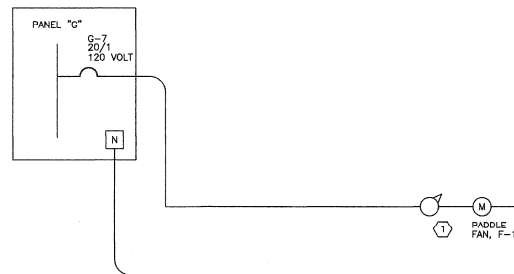

1  
E4  
PADDLE FAN CONTROL DIAGRAM  
NTS

## NOTES:


- ① ELECTRONIC SPEED CONTROL - SUPPLIED OR RECOMMENDED BY THE PADDLE FAN MANUFACTURER.

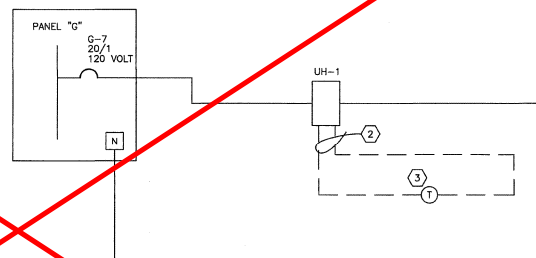

2  
E4  
HEATING CONTROL WIRING DIAGRAM  
NTS

## NOTES:

- ① NOT USED.
- ② THERMOSTAT WIRE - CAN RUN EXPOSED BUT MUST BE STAPLED TO WAINSCOT 24 INCHES O.C.
- ③ THERMOSTAT FOR UNIT HEATER - NON MERCURY TYPE.

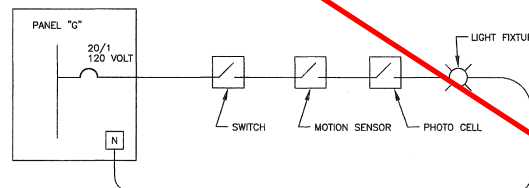

3  
E4  
EXTERIOR LIGHTING CONTROL DIAGRAM  
NTS

## SREB GENERAL NOTES:

1. THE WORK SHOWN ON DETAILS 1/E4 AND 2/E4 IS APPLICABLE TO THE HEATED BUILDING, SREB #1.
2. THE WORK SHOWN ON DETAILS 3/E4, 4/E4 AND 5/E4 IS APPLICABLE TO THE HEATED BUILDING, SREB #1 AND TO THE UNHEATED BUILDING, SREB #2.

AS-BUILT

Project Engineer: *[Signature]* Date: 3/1/18  
Hooper Bay Airport Improvements 57419



PLAN PREPARED BY MBA CONSULTING ENGINEERS, INC.

BY	DATE	REVISION


STATE OF ALASKA  
DEPARTMENT OF TRANSPORTATION  
AND PUBLIC FACILITIES  
CENTRAL REGION

HOOPER BAY AIRPORT  
HOOPER BAY, ALASKA  
SNOW REMOVAL EQUIPMENT BUILDING  
AIP NUMBER: 3-02-0126-006-2014

HEAT CONTROLS & POWER DETAILS

DATE: 4/3/2015  
SHEET: E4 OF E4  
AS-BUILT SHEET




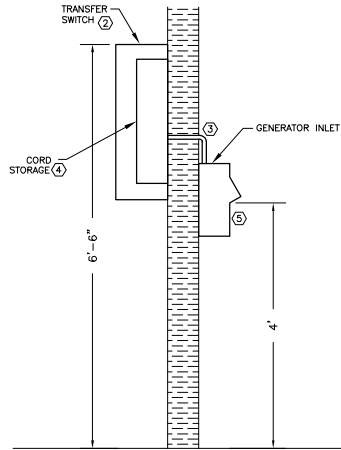

3  
 E4  
 NTS  
**PANEL "G" - GENERATOR INLET ELEVATION**


**DETAIL NOTES:**

- ① NOT USED.
  - ② 60-AMP 250-VOLT NON-FUSED TWO-POLE DOUBLE-THROW TRANSFER SWITCH, SQUARE-D CATALOG NO. DTU222 OR APPROVED EQUAL.
  - ③ SEAL CONDUIT PENETRATION ON INSIDE AND OUTSIDE BETWEEN THE INTERIOR AND EXTERIOR OF THE BUILDING WITH DUX SEAL.
  - ④ PROVIDE A 20-FOOT "ARCTIC" POWER CORD CONTAINING THREE #8 AWG POWER CONDUCTORS AND ONE #10 AWG GROUND CONDUCTOR WITH A CS63-64C\* CONNECTOR ON ONE END AND A CS63-65C\* PLUG ON THE OTHER. PROVIDE THE FOLLOWING 36-INCH LONG ADAPTER CORDS.
    - (A) 1-4C #10 POWER CORD WITH A CS63-64C\* CONNECTOR ON ONE END AND A NEMA-L14-30 PLUG ON THE OTHER.
    - (B) 1-4C #12 POWER CORD WITH A CS63-64C\* CONNECTOR ON ONE END AND A NEMA-L14-20 PLUG ON THE OTHER. PROVIDE WALL CABINET NEXT TO PANEL-G TO STORE THE CORDS.
  - ⑤ MOUNT A CS63-75C\* (MALE) GENERATOR FLANGED INLET IN A NEMA-3R GALVANIZED/PAINTED ENCLOSURE WITH THE INLET 48 INCHES ABOVE THE FLOOR LEVEL - MIWEST ELECTRIC PRODUCTS CAT. NO. UG50N OR APPROVED EQUAL. (OTHER ACCEPTED MANUFACTURERS - GE, CROUSE-HINDS).
- \* CALIFORNIA STANDARD 125/250-VOLT, 3-POLE, 4-WIRE, NON-NEMA, 50-AMP WIRING DEVICE, LEVITON CATALOG # AS SHOWN, OR APPROVED EQUAL. (OTHER ACCEPTED MANUFACTURERS - CROUSE-HINDS, APPLETON).

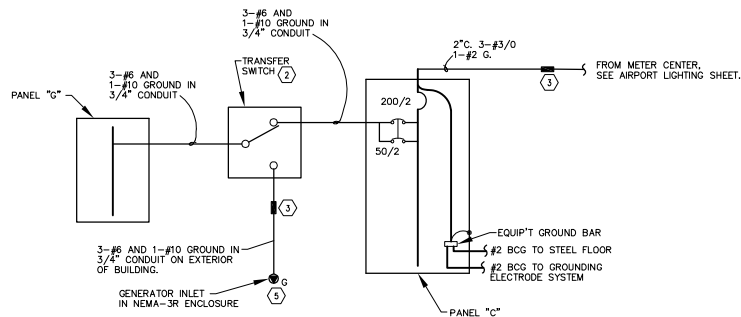


4  
 E4  
 NTS  
**POWER ONE LINE DIAGRAM**

NOTE: REFER TO AIRPORT LIGHTING SHEETS FOR METER PANEL LOCATION AND DETAIL.

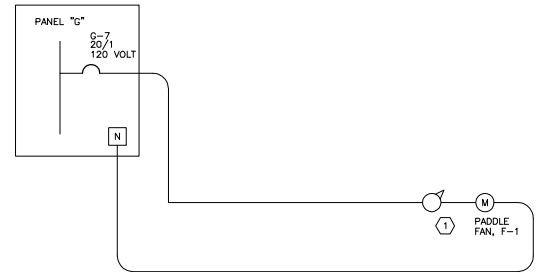


1  
 E4  
 NTS  
**PADDLE FAN CONTROL DIAGRAM**

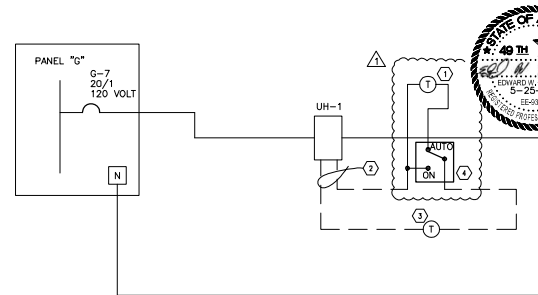

2  
 E4  
 NTS  
**HEATING CONTROL WIRING DIAGRAM**

- NOTES:**
- ① ELECTRONIC SPEED CONTROL - SUPPLIED OR RECOMMENDED BY THE PADDLE FAN MANUFACTURER.

- NOTES:**
- ① EXTERIOR THERMOSTAT SET TO CLOSE CONTACTS WHEN BELOW 50°F. HONEYWELL T775 SERIES 2000 CONTROLLER WITH T775-SENS-OAT TEMPERATURE SENSOR OR AS APPROVED.
  - ② THERMOSTAT WIRE - CAN RUN EXPOSED BUT MUST BE STAPLED TO WAINSCOT 24 INCHES O.C.
  - ③ THERMOSTAT FOR UNIT HEATER - NON MERCURY TYPE.
  - ④ KEYED (AUTO - ON) SWITCH (SHOWN IN AUTO POSITION), KEY THE SAME AS THE RECEPTACLE HOA SWITCH.

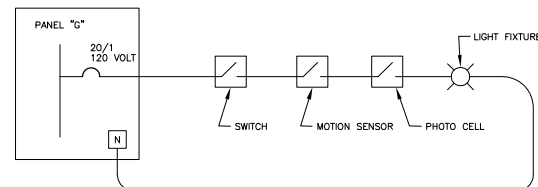

5  
 E4  
 NTS  
**EXTERIOR LIGHTING CONTROL DIAGRAM**

**SREB GENERAL NOTES:**

- 1- THE WORK SHOWN ON DETAILS 1/E4 AND 2/E4 IS APPLICABLE TO THE HEATED BUILDING, SREB #1.
- 2- THE WORK SHOWN ON DETAILS 3/E4, 4/E4 AND 5/E4 IS APPLICABLE TO THE HEATED BUILDING, SREB #1 AND TO THE UNHEATED BUILDING, SREB #2.

**AS-BUILT**  
 Project Engineer: *[Signature]* Date: 3/1/18  
 Hooper Bay Airport Improvements 57419



PLAN PREPARED BY MBA CONSULTING ENGINEERS, INC.

EWC	5-24-16	UNIT HEATER CONTROL
BY	DATE	REVISION

STATE OF ALASKA  
 DEPARTMENT OF TRANSPORTATION  
 AND PUBLIC FACILITIES  
 CENTRAL REGION

HOOPER BAY AIRPORT  
 HOOPER BAY, ALASKA  
 SNOW REMOVAL EQUIPMENT BUILDING  
 AIP NUMBER: 3-02-0126-006-2014

HEAT CONTROLS & POWER DETAILS

DATE: 4/3/2015  
 SHEET: E4 OF E4  
 AS-BUILT SHEET: